
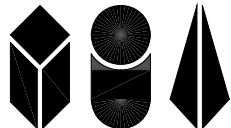
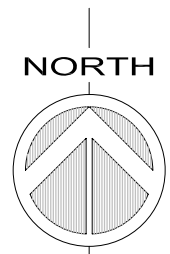


Total rentable area: 872 sq. ft.

Total usable area: 779 sq. ft.

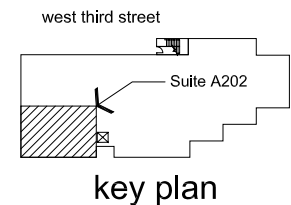

Roberts | Jones Associates, Inc.  
 Architecture Planning Programming  
 2525 East Arizona Biltmore Circle  
 Suite B128  
 Phoenix, Arizona 85016  
 602-955-7575  
 602-955-6383 (FAX)

## HAYDEN STATION - BUILDING A SUITE 202

310 SOUTH MILL AVENUE  
 TEMPE, ARIZONA

Scale: 1/8"=1'-0"

Date: April 04, 2013

Drawing: Leasing Plan