



PIMA CROSSING
 SUITE: 8116 #101
 LOD PLAN
 AREA: 2015 SF

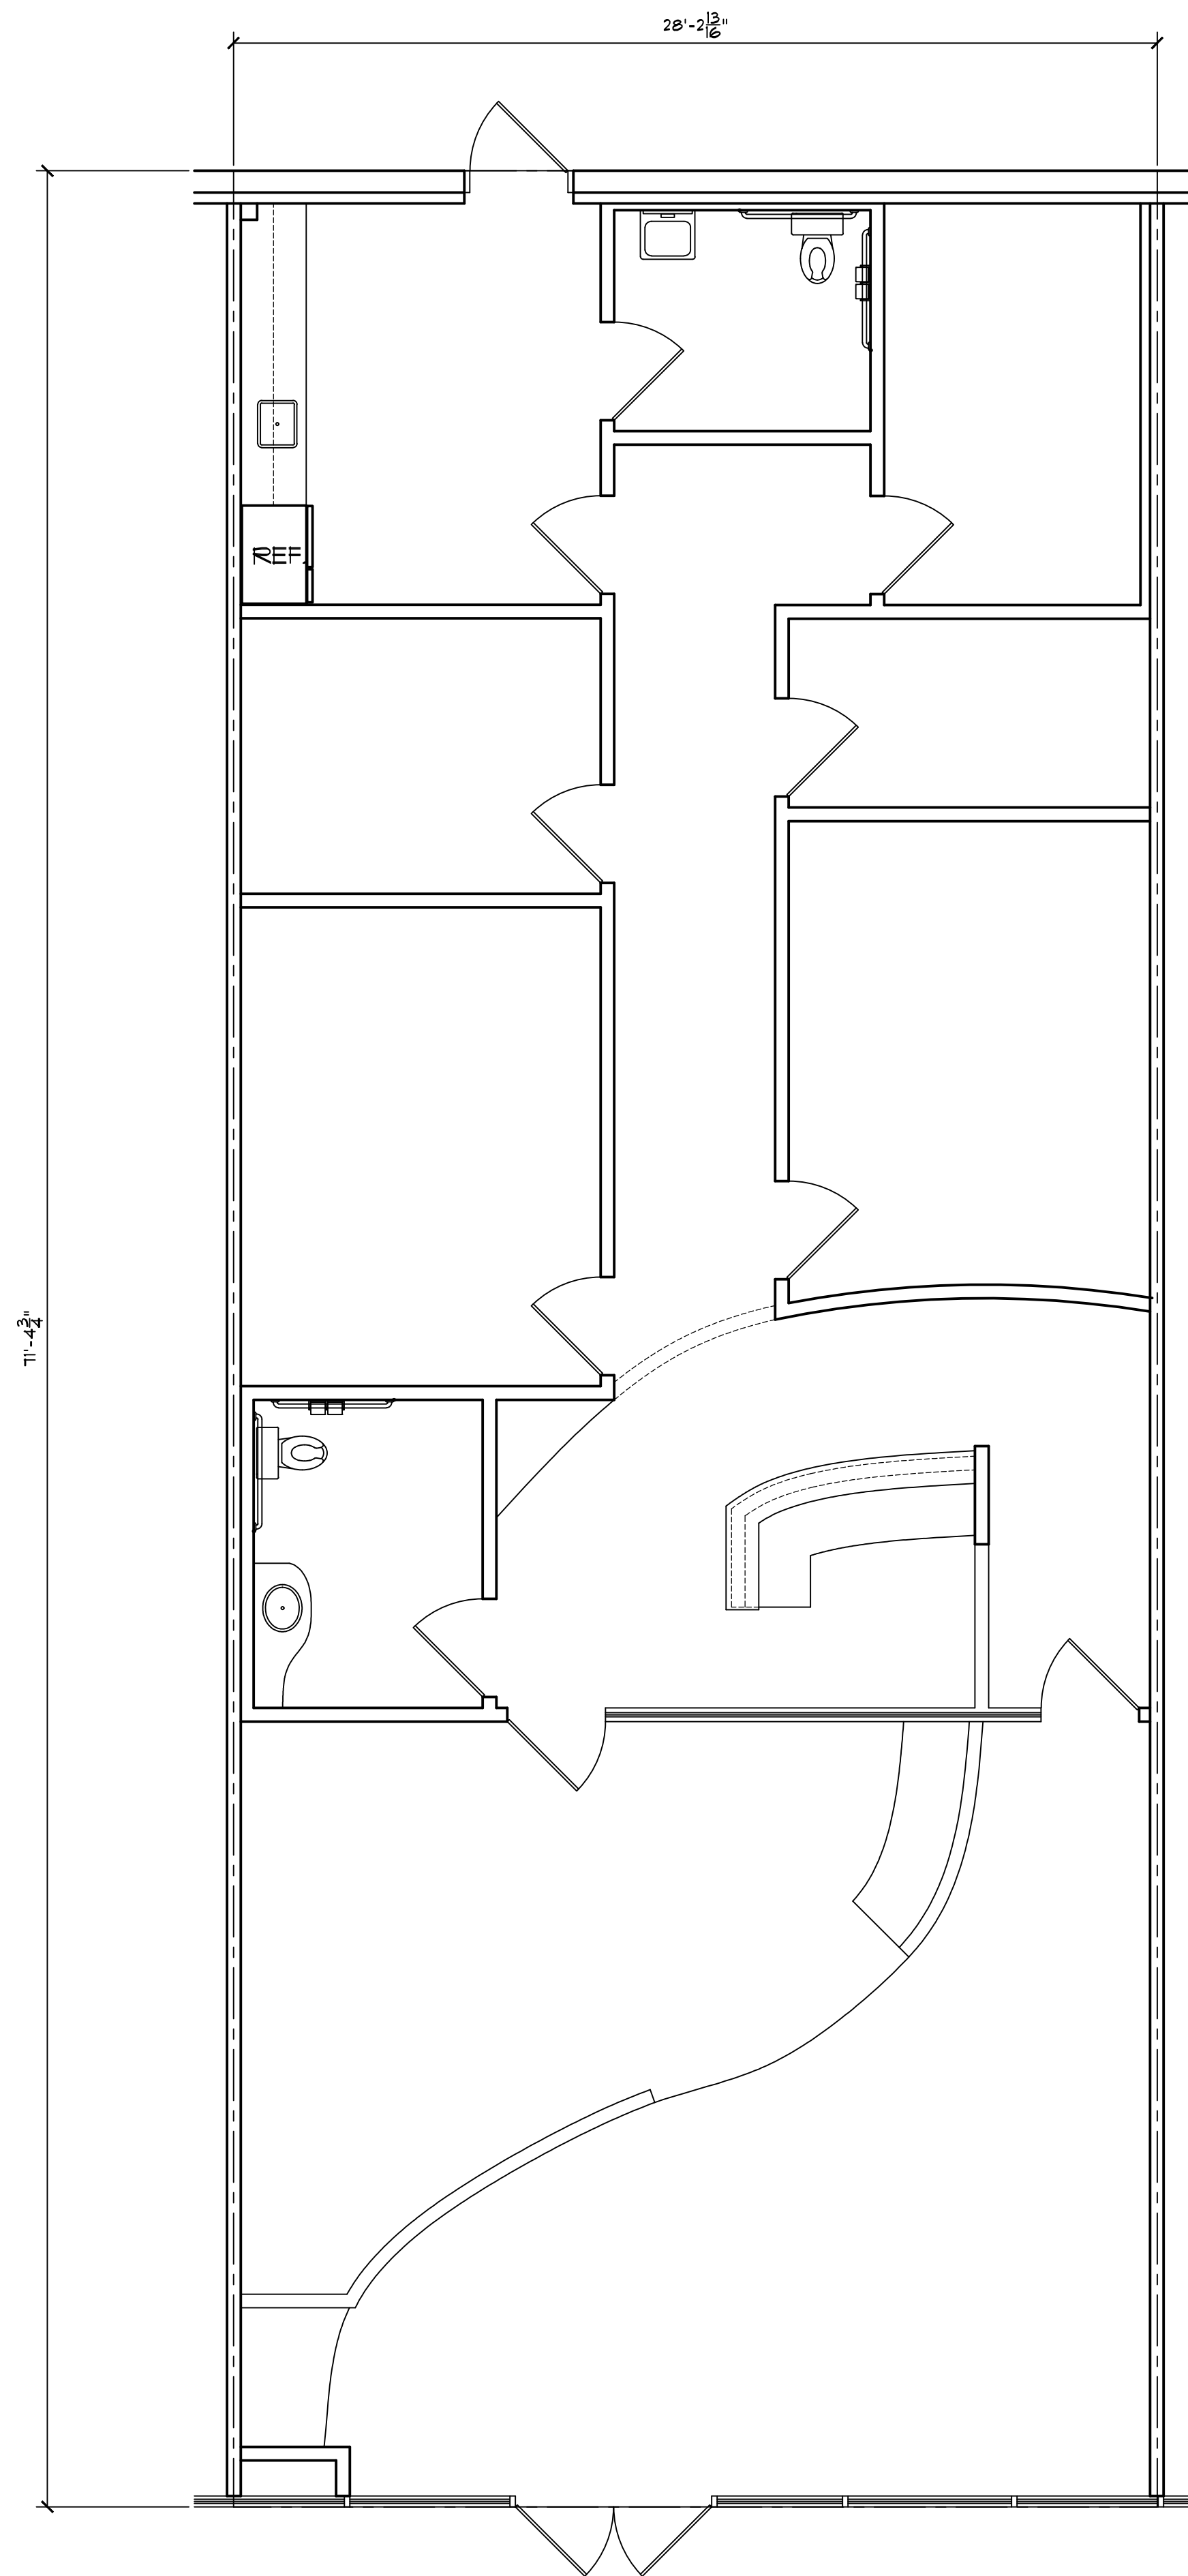

PIMA CROSSING
 SUITE: 8116 #101
 FLOOR PLAN
 AREA: 2015 SF

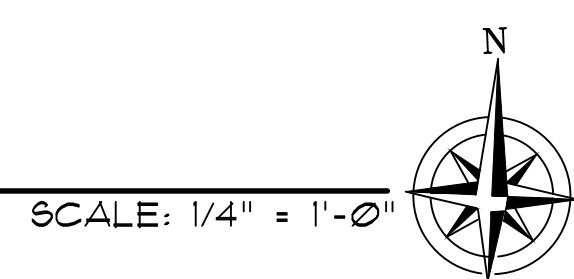